

STATE OF UTAH
DEPARTMENT OF NATURAL RESOURCES
DIVISION OF OIL, GAS AND MINING
1594 West North Temple - Suite 1210
Box 145801
Salt Lake City, Utah 84114-5801
Telephone: (801) 538-5291
Fax: (801) 359-3940

LARGE MINING OPERATIONS 2007 PROGRESS REPORT
January 1, 2007 to December 31, 2007

The information required in this form are based on provisions of the Mined Land Reclamation Act, Title 40-8, and the rules as under the Utah Minerals Regulatory Program.

1. Mine Permit Number: M/023/023
2. Mine Name: Levan - Henry
3. Name of Operator/Permittee: Sunroc Corporation
Note: If Operator's address, company representative or phone number have changed, please provide a replacement page to the Notice of Intention.
4. Mine Location: 3 miles south of Levan on Hwy 28 (East side)
5. Report the gross amount of ore mined and waste moved, as well as the arrangement, positioning, or distribution of the material:

Gross Ore Mined	<u>0</u> Tons, or <u>0</u> yd ³
Waste Material Moved	<u>0</u> Tons, or <u>0</u> yd ³
New Disturbance	<u>0</u> Acres during 2007
Area Reclaimed	<u>6</u> Acres during 2007
Total Disturbed Area	<u>12.32</u> Acres*

Was the ore shipped off site? If not, where is the ore located? yes


Where is the waste located? west end of processing pad

*Total life of mine disturbance to the end of 2007.

6. Briefly describe the reclamation work performed during the past year. A map showing reclaimed areas and dates is suggested. (Submit form MR-SITE for an application for full or partial bond/site release).
none
7. Include an updated map depicting surface disturbance and reclamation performed during the year, prepared in accordance with Rule R647-4-105.

I hereby certify, under penalties of law, the information provided in this report is true and correct to the best of my knowledge and belief.

Name (Typed or Print): Tony L Christofferson
Title of Operator: property / Environmental Mgr.
Signature of Operator: Tony L Christofferson
Date: 1-31-08

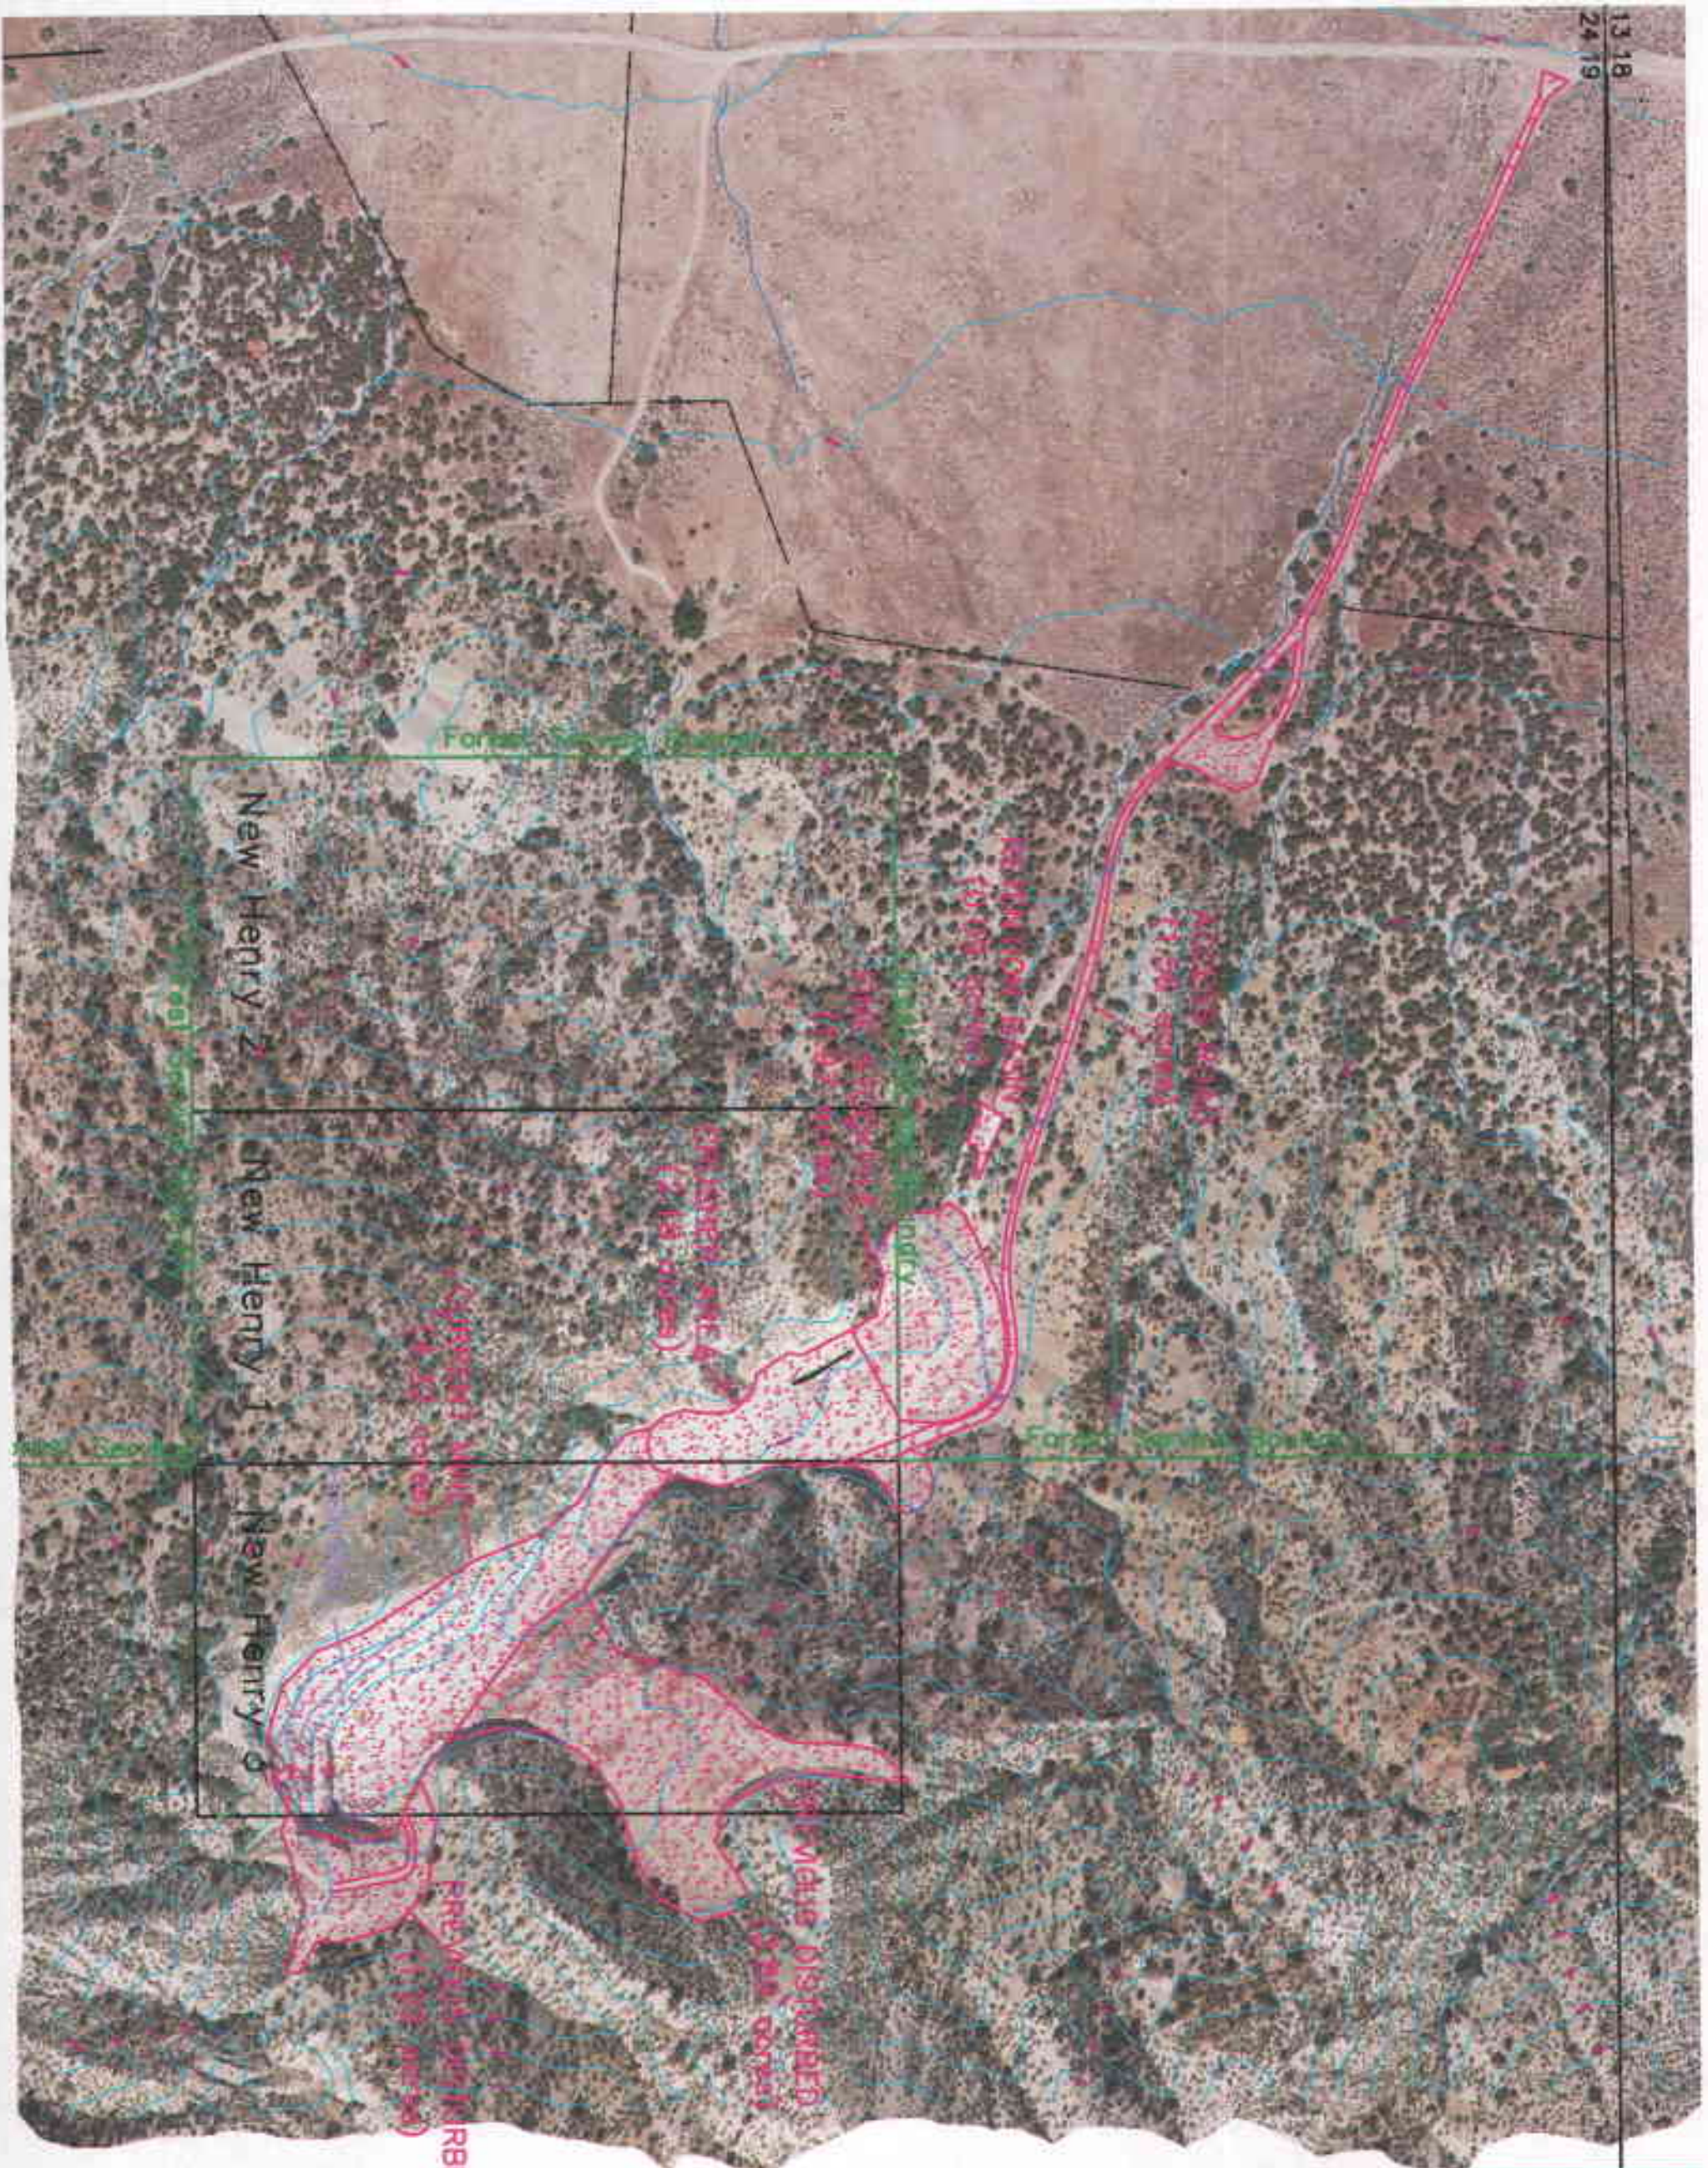

Scale 1" = 300'

DISTURBED AREA MAP
of the
LEVAN HENRY MINE


E 1/2, SE 1/4, NW 1/4,
Sec. 19, T 15 S, R 1 E,
SLB & M.

RECEIVED

JAN 31 2008